



C. Earl Hunter, Commissioner

Promoting and protecting the health of the public and the environment.

PUBLIC NOTICE AMENDMENT REQUEST

The permittee for P/N# **OCRM-07-951, Welles Murphey**, has requested an amendment to that issued permit. Specifically, the applicant proposes to add 6 single guide dolphin piles around an existing floating dock.. The proposed amendment is for modifications to a private dock located on and adjacent to Broad Creek at Buck Island off Brans Point, Hilton Head Island, Beaufort County, South Carolina.

Written comments will be received on this amendment request until September 8, 2008 at the address listed below. For further information please contact the project manager, Georgie Madlinger, 843-846-9400.


August 29, 2008

SOUTH CAROLINA DEPARTMENT OF HEALTH AND ENVIRONMENTAL CONTROL


Ocean and Coastal Resource Management

Charleston Office • 1362 McMillan Avenue, Suite 400 • Charleston, SC 29405

Phone: 843-953-0200 • Fax: 843-953-0201 • www.scdhec.gov

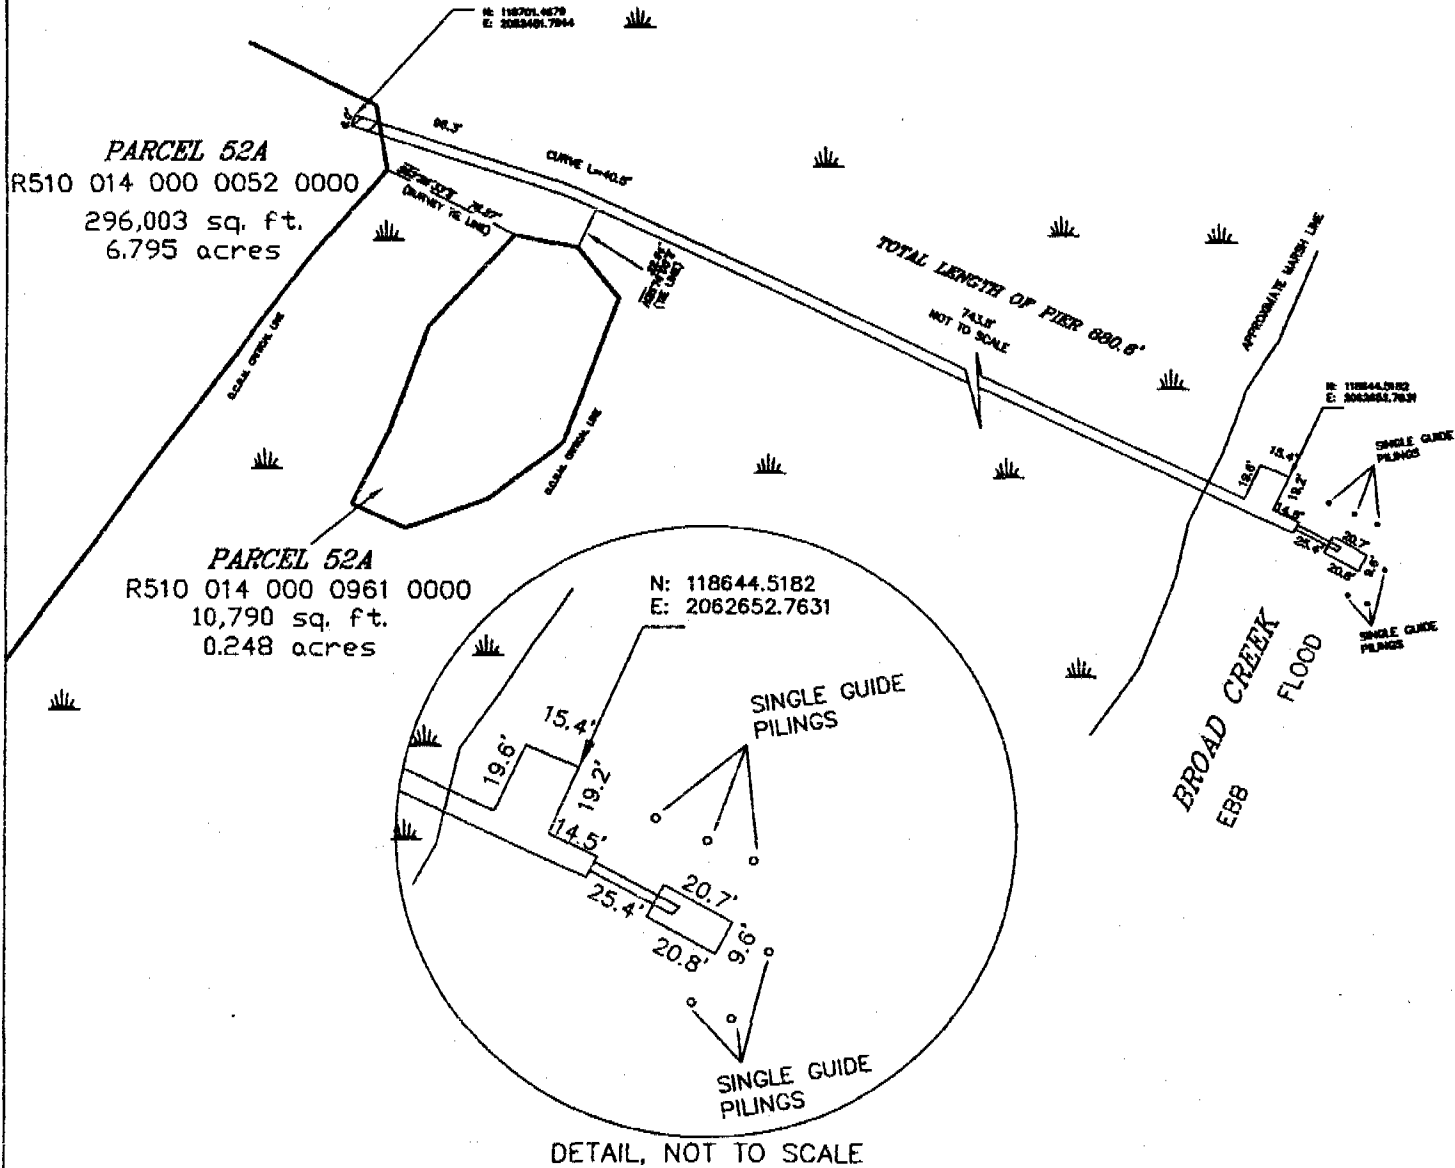

I HEREBY CERTIFY THAT THE DISTANCES THAT PERTAIN TO
PIER, PIERHEAD AND FLOATS ARE CORRECT AND THAT
THERE ARE NO ENCROACHMENTS ACROSS EXTENDED PROPERTY LINES

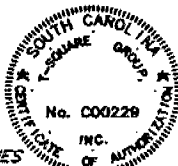

FORREST F. BAUGHMAN, FLS
SC REGISTERED LAND SURVEYOR # 4922
PO BOX 330 BLUFFTON, SC 29910

APPLICANT:
WELLES MURPHEY
ACTIVITY:
AN AS-BUILT SURVEY OF BUCK ISLAND
P/N # OCRM 07-951

LOCATION:
R510 014 000 0052 0000
R510 014 000 0961 0000
100 BRAMS POINT RD.
HILTON HEAD ISLAND
COUNTY: BEAUFORT
DATE: 8/15/2008

ADJACENT PROPERTY OWNERS:

THIS IS AN ISLAND.

RECEIVED

AUG 18 2008

DHEC-OCRM
BEAUFORT OFFICE